
# PLAN

SCALE 1:500

0 — 25 m

N

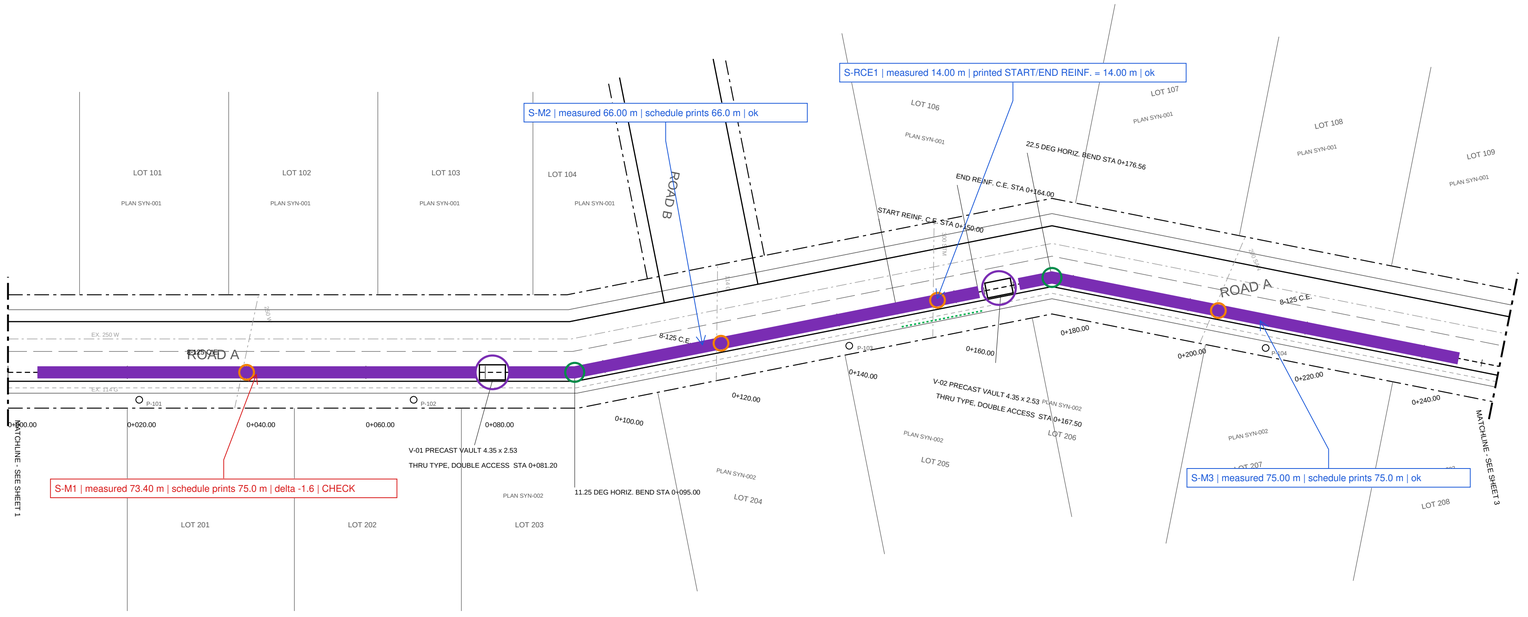


## GENERAL NOTES

1. ALL DIMENSIONS IN METRES UNLESS NOTED. STATIONS ALONG DUCT CENTRELINE.
2. MIN. COVER 1.0 m TO TOP OF CONCRETE ENCASEMENT (C.E.).
3. MAINTAIN 0.9 m HORIZONTAL AND 0.3 m VERTICAL SEPARATION FROM OTHER UTILITIES.
4. REINFORCED C.E. REQUIRED WHERE DUCT PASSES BELOW A RIGID UTILITY.
5. STUB DUCTS 1.5 m FROM EACH VAULT WALL.
6. EXISTING UTILITIES SHOWN FOR REFERENCE ONLY. LOCATE BEFORE EXCAVATION.
7. RESTORE TRENCH SURFACE: TRENCH WIDTH PLUS 0.2 m EACH SIDE.

## DUCT SCHEDULE


| RUN | ID | FROM | TO | LENGTH m |
|---|---|---|---|---|
| RUN 1 | S-M1 | 0+005.00 | 0+078.40 | 75.0 |
| RUN 2 | S-M2 | 0+084.00 | 0+150.00 | 66.0 |
| RUN 3 | S-RCE1 | 0+150.00 | 0+164.00 | 14.0 |
| RUN 4 | S-M3 | 0+171.00 | 0+246.00 | 75.0 |

## LEGEND

- PROPOSED DUCT (C.E.)
- CURB
- PROPERTY LINE
- EX. WATER
- EX. GAS

# PROFILE

H 1:500 V 1:100

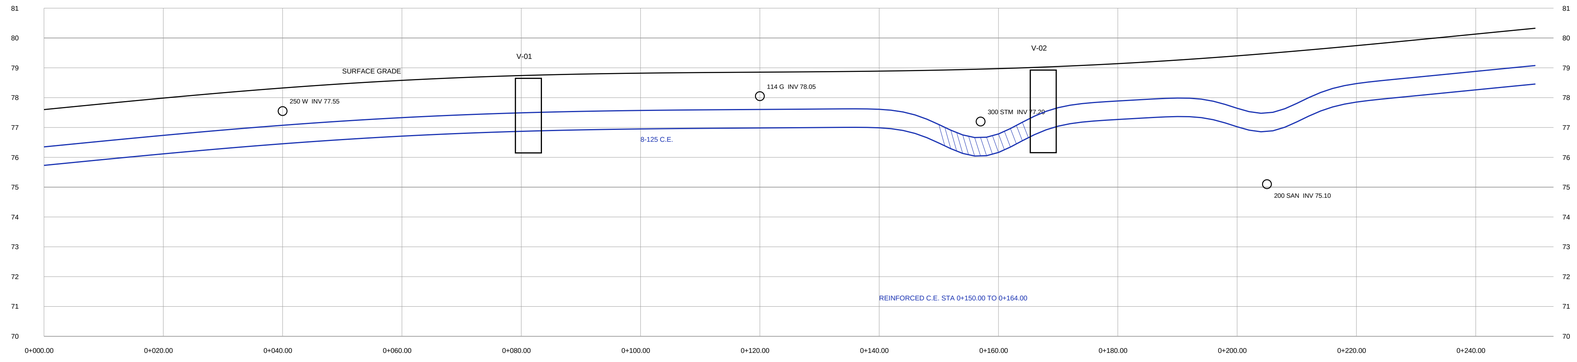


SYNTHETIC TRAINING SHEET
NOT A REAL PROJECT. Every street, lot, station, elevation, structure and length on this sheet is invented. No owner, no site, no tender.

UNDERGROUND DUCT AND STRUCTURES

ROAD A STA 0+000 TO 0+253.03

PLAN AND PROFILE

DWG NO. SYN-U-0002 REV A